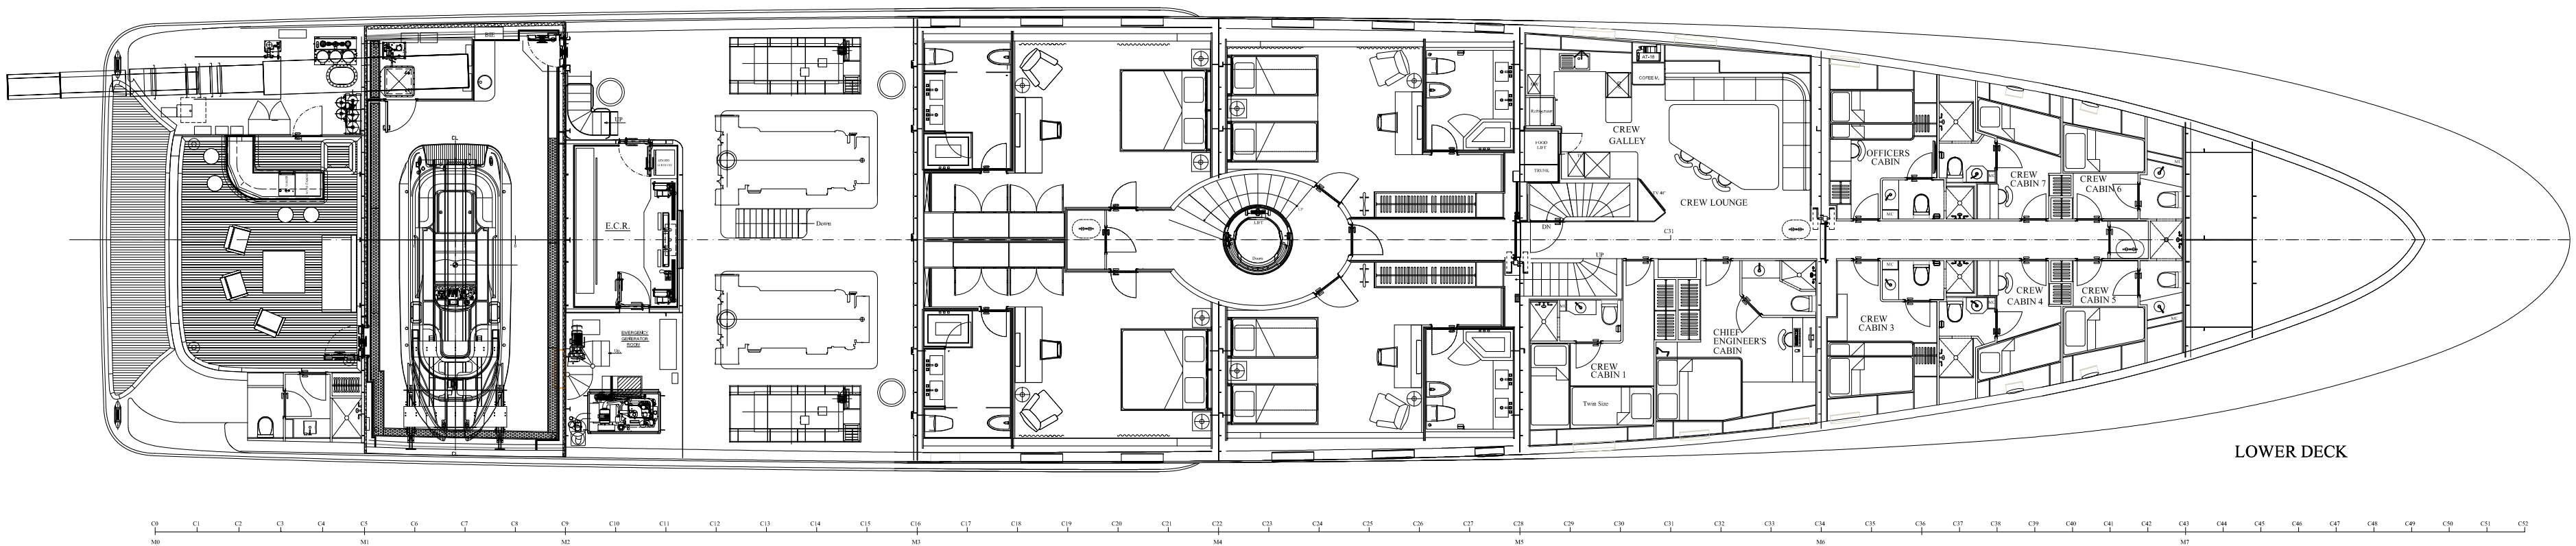
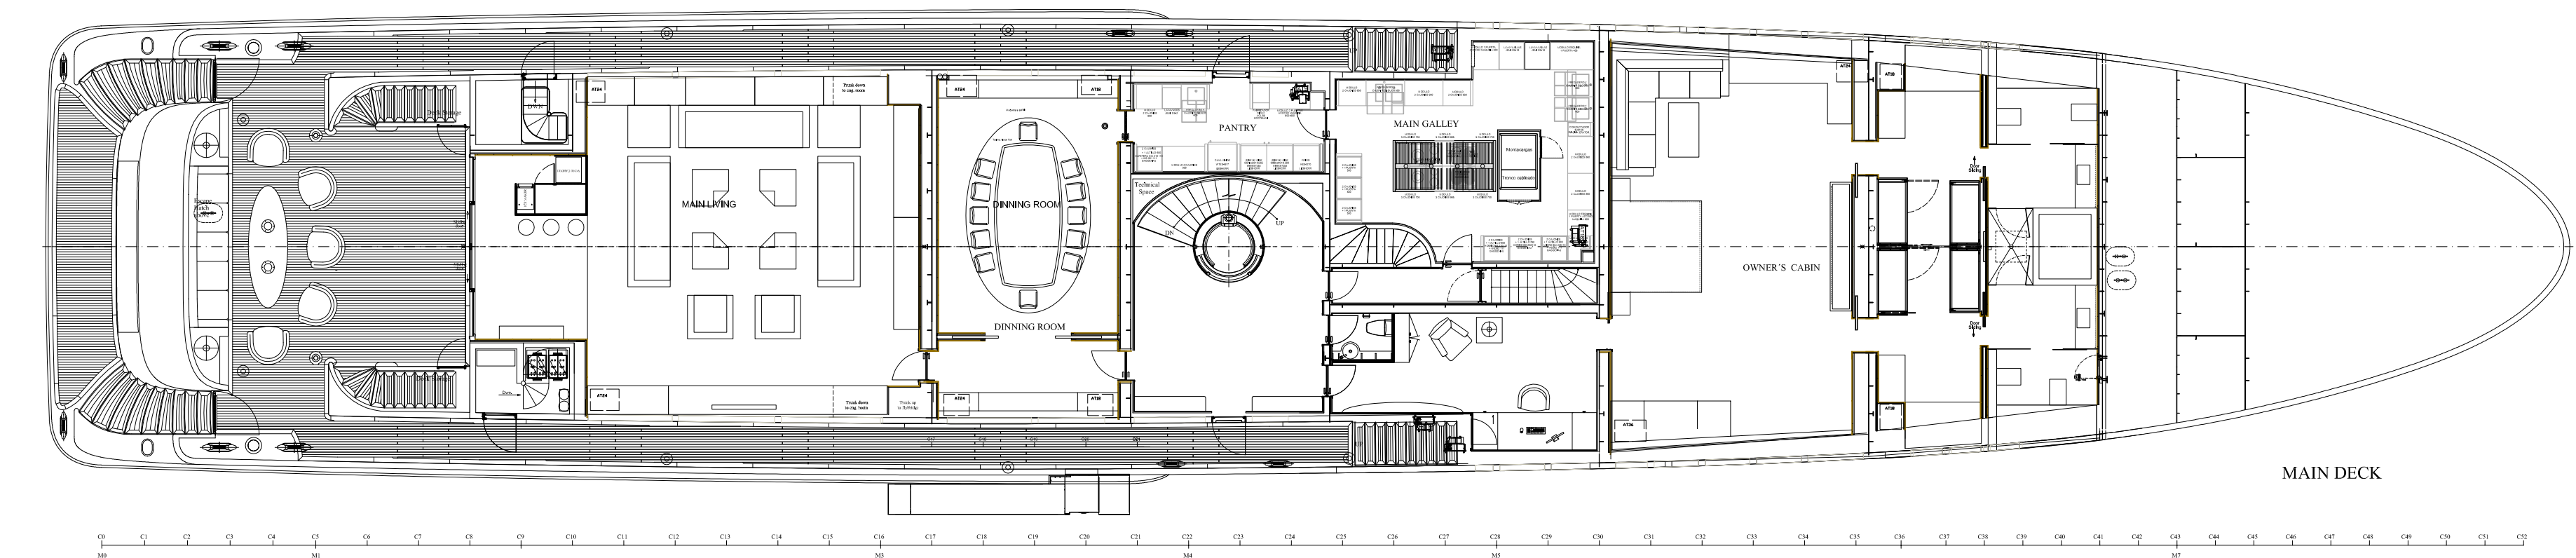
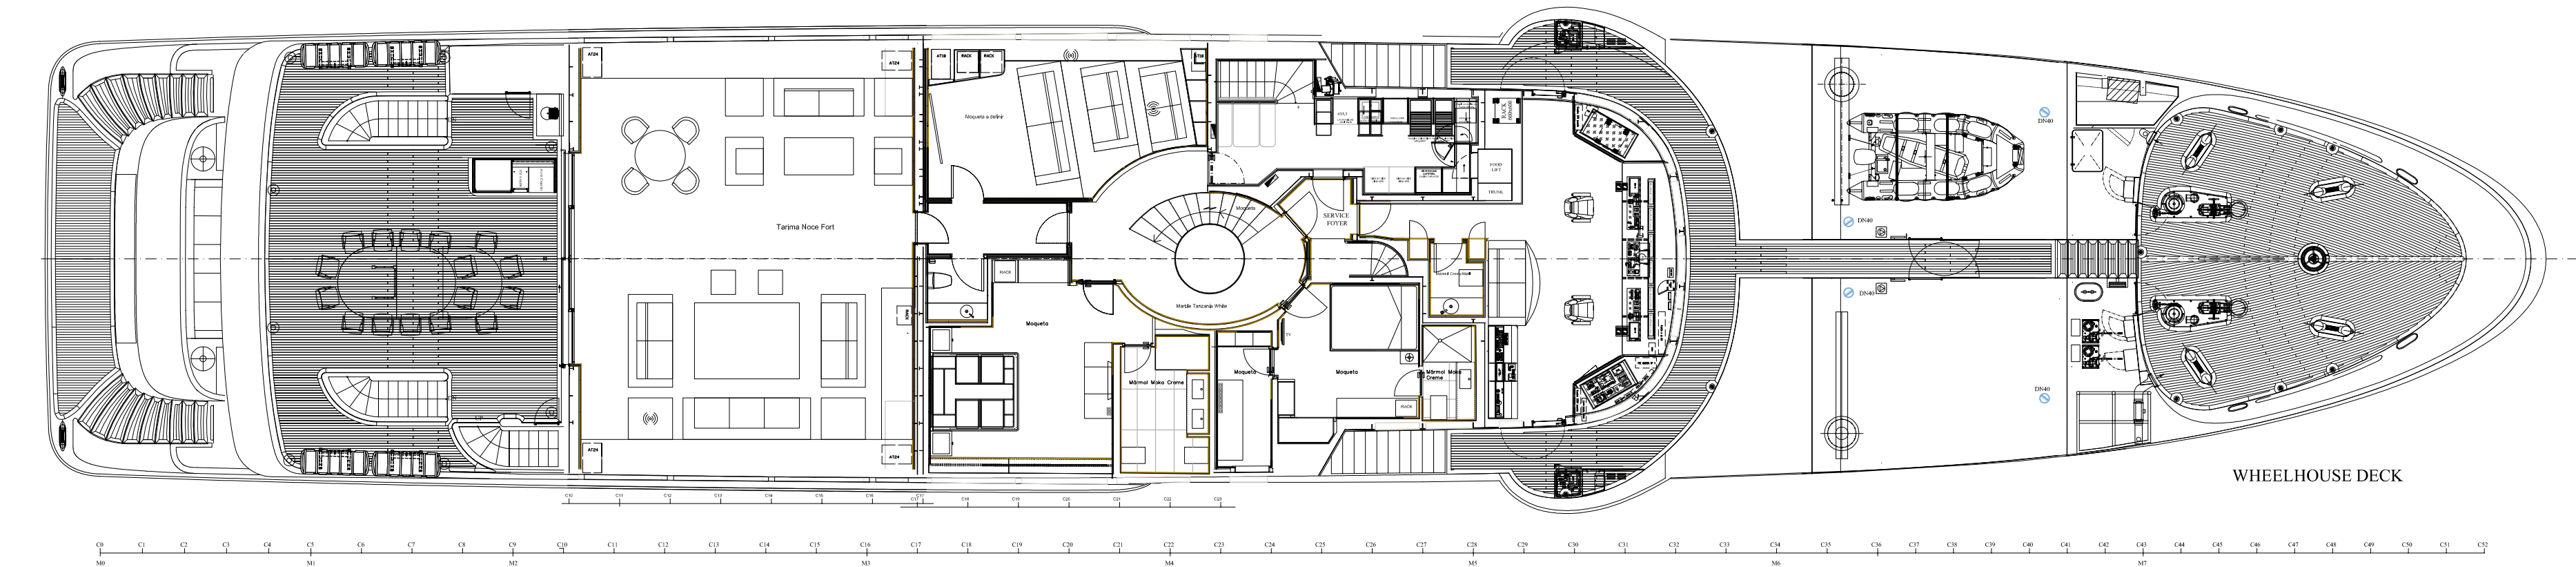
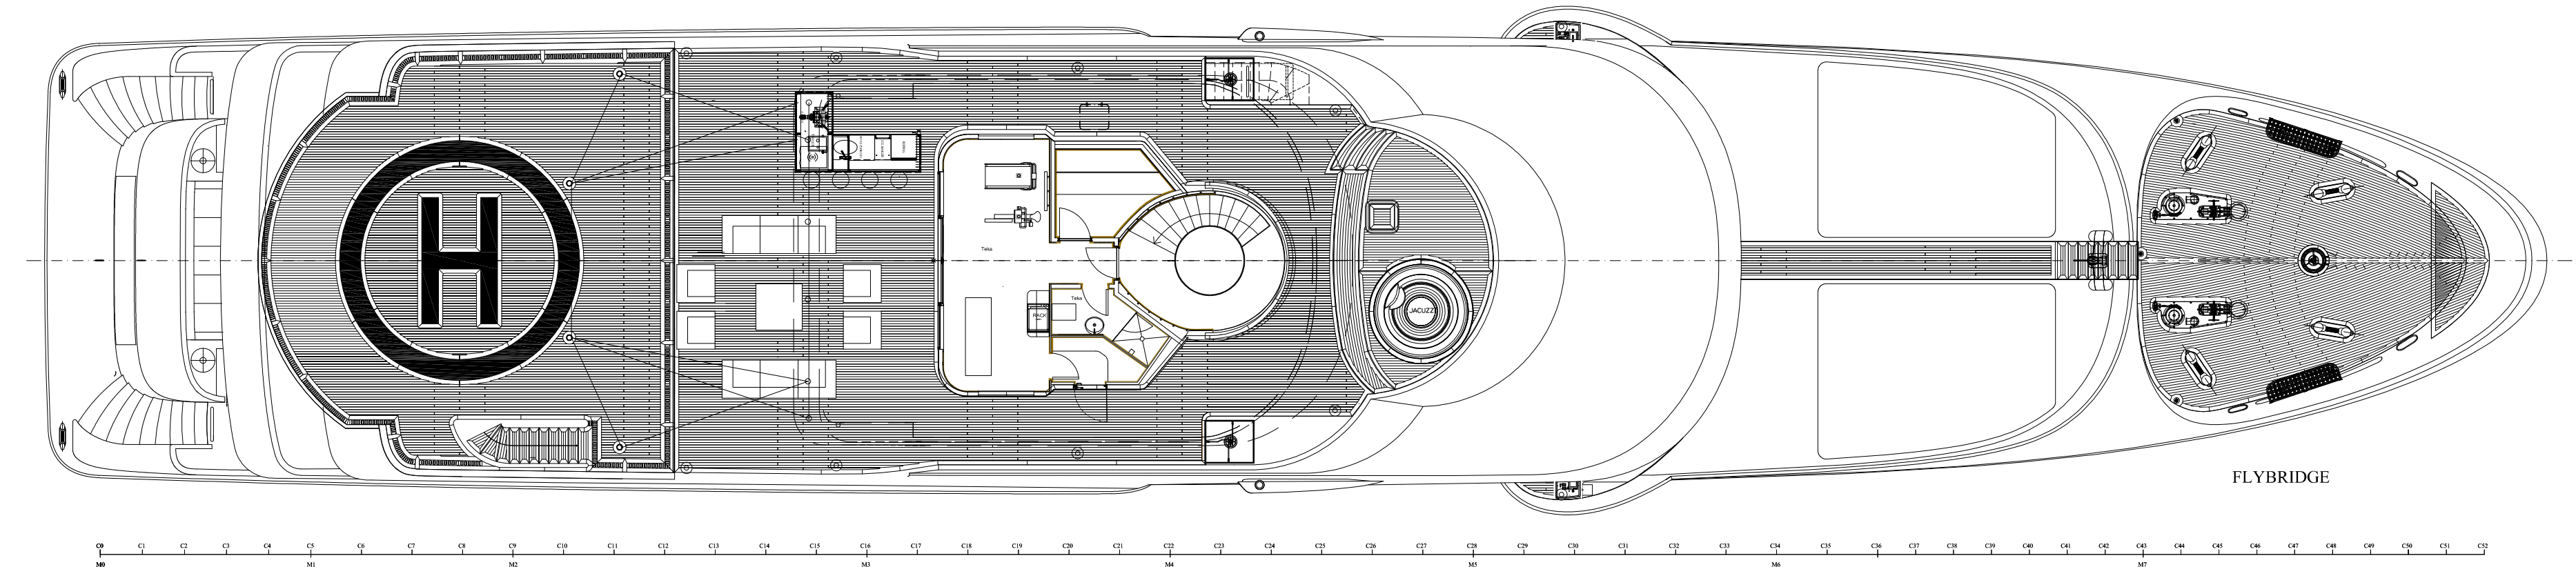
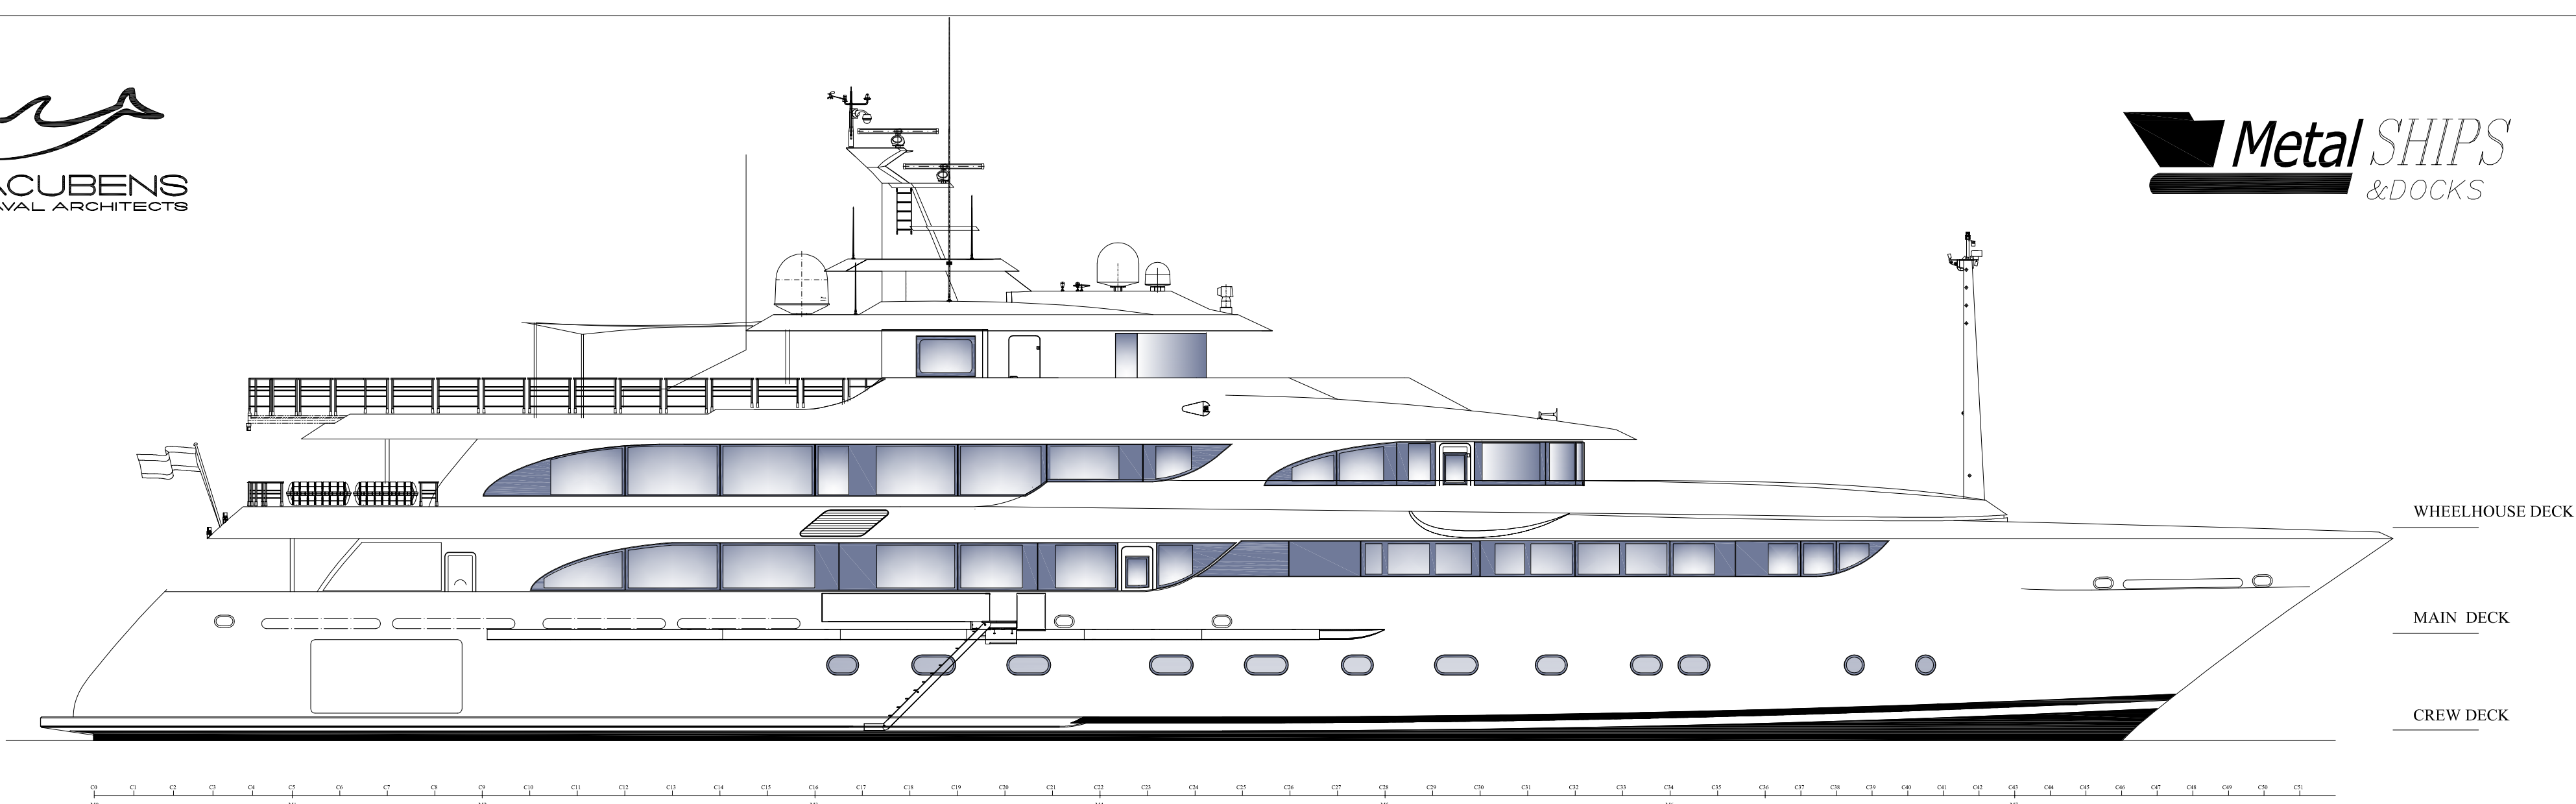


CARACTERISTICAS / MAIN PARTICULARS

Eslora / lenght	59.00 M	Velocidad max. / max. speed	16.5 kn
Manga / Beam	10.70 M	Velocidad crucero / cruise speed	14 kn
Calado medio / medium Draft	3.094 M	Autonomia a 12 N / 12knts Range	6500 nm
despl. media carga / displ. medium load	770 Tm	Fuel capacidad / Fuel capacity	134.240 l
MM.PP / Main Engines	2x 2000kw_1600 r.p.m	Capacidad agua dulce / FW capacity	21.940 l
MM.EM / Emergency Eng.	2x175kw + 1x 88kw	Acomodación / Accommodation	12 pas
			16 crew

COTA DE CLASE / CLASS NOTATION: Bureau Veritas I HULL* MACH YACHT-MOTORS-S UNRESTRICTED MCA LY3

POS.	DENOMINATION	QTY.	MATERIAL	N.D.	REF.	COMMENTS
J	Marcos 280417		Updated			
I	Marcos 060916		Updated as built			
H	Marcos 210316		Updated			
G	Marcos 280216		Updated			
F	Marcos 151215		Updated			
E	Marcos 23.09.15		Updated			
D	Marcos 170915		Updated			
C	Marcos 020715		Updated			
B	Marcos 14/05/15		Add class notation			
A	Marcos 07/05/15		Add main characteristics and various			
REV.	NAME	DATE	APPR. BY	DESCRIPTION		
DRAWN BY	Marcos	090215		TITLE:		
CHECKED BY						
APPR. BY						
SCALE:	APPROVAL					
1/125	B.V.					
	D.V.					
				DISPOSICION GENERAL GENERAL ARRANGEMENT		
				 Shipbuilding & Shiprepair		
				BUILDING:	DRAW. NR.	
				297	297.101.001	